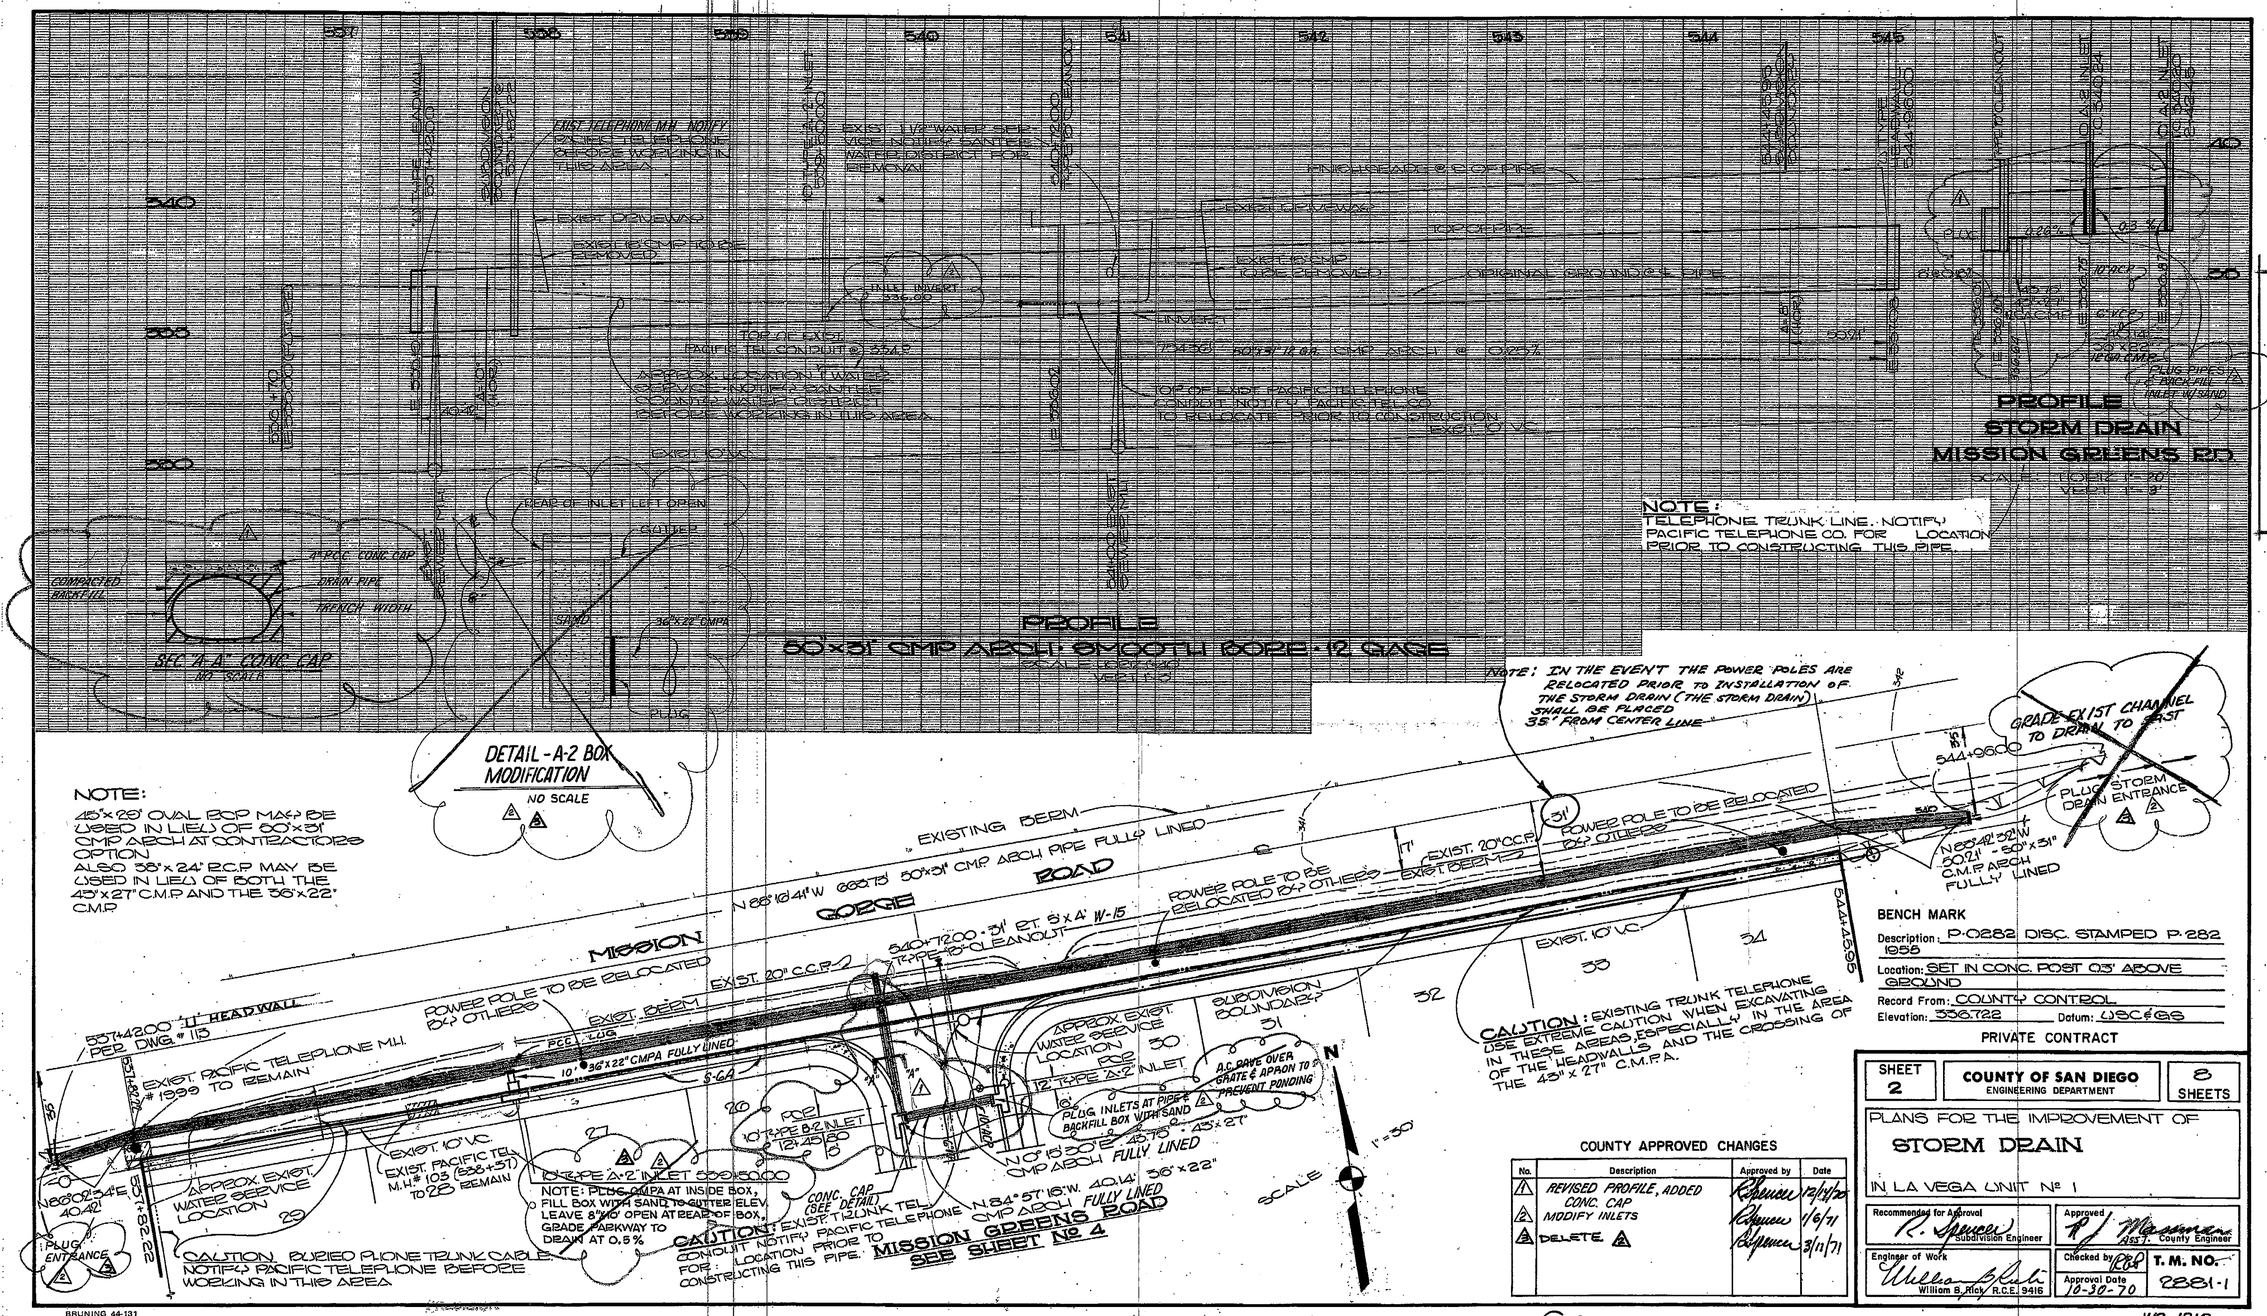

AS BUILT - EX. INLETS & PIPES

BENCH MARK

Description: P-0282 DISC. STAMPED P-282 1955

Location: SET IN CONC. POST 0.3' ABOVE GROUND

Record From: COUNTY CONTROL

Elevation: 336.722 Datum: USC&GS

PRIVATE CONTRACT

COUNTY APPROVED CHANGES

No.	Description	Approved by	Date
1	REVISED PROFILE, ADDED CONC. CAP	R. Spencer	12/14/70
2	MODIFY INLETS	R. Spencer	1/6/71
3	DELETE 2	R. Spencer	3/11/71

SHEET 2	COUNTY OF SAN DIEGO ENGINEERING DEPARTMENT	8 SHEETS

PLANS FOR THE IMPROVEMENT OF

STORM DRAIN

IN LA VEGA UNIT No 1

Recommended for Approval: R. Spencer, Subdivision Engineer	Approved: R. J. Massman, Asst. County Engineer
Engineer of Work: William B. Rick, R.C.E. 9416	Checked by: RCB; Approval Date: 10-30-70; T. M. NO. 2881-1

WS-1018

Rick ENGINEERING COMPANY
3557 Kenyon St. 222-0348 San Diego, Calif.
JOB NO. 3334-D

BRUNING 44-131

APR 1 1971
MICROFILMED